



DEPARTMENT OF REGULATORY AND ECONOMIC RESOURCES (RER)
BOARD AND CODE ADMINISTRATION DIVISION

NOTICE OF ACCEPTANCE (NOA)

MIAMI-DADE COUNTY
PRODUCT CONTROL SECTION
11805 SW 26 Street, Room 208
Miami, Florida 33175-2474
T (786) 315-2590 F (786) 315-2599
www.miamidade.gov/economy

Arrow United Industries
450 Riverside Drive
Wyalusing, PA 18853

SCOPE:

This NOA is being issued under the applicable rules and regulations governing the use of construction materials. The documentation submitted has been reviewed and accepted by Miami-Dade County RER-Product Control Section to be used in Miami Dade County and other areas where allowed by the Authority Having Jurisdiction (AHJ).

This NOA shall not be valid after the expiration date stated below. The Miami-Dade County Product Control Section (In Miami Dade County) and/or the AHJ (in areas other than Miami Dade County) reserve the right to have this product or material tested for quality assurance purposes. If this product or material fails to perform in the accepted manner, the manufacturer will incur the expense of such testing and the AHJ may immediately revoke, modify, or suspend the use of such product or material within their jurisdiction. RER reserves the right to revoke this acceptance, if it is determined by Miami-Dade County Product Control Section that this product or material fails to meet the requirements of the applicable building code.

This product is approved as described herein, and has been designed to comply with the Florida Building Code, including the High Velocity Hurricane Zone.

DESCRIPTION: Model EAV-81 8" Deep Aluminum Louver

APPROVAL DOCUMENT: Drawing No. 1624, titled "Model EAV-81 Impact Louver System", sheets 1 through 3 of 3, dated 11/12/2008, with revision A1, dated 11/08/2011, prepared by W. W. Schaefer Engineering & Consulting, P.A. signed and sealed by Warren. W. Schaefer, P.E., bearing the Miami-Dade County Product Control revision stamp with the Notice of Acceptance number and expiration date by the Miami-Dade County Product Control Section.

MISSILE IMPACT RATING: Large and Small Missile Impact Resistant

LABELING: Each unit shall bear a permanent label with the manufacturer's name or logo, city, state, model/series, and following statement: "Miami-Dade County Product Control Approved", unless otherwise noted herein.

RENEWAL of this NOA shall be considered after a renewal application has been filed and there has been no change in the applicable building code negatively affecting the performance of this product.

TERMINATION of this NOA will occur after the expiration date or if there has been a revision or change in the materials, use, and/or manufacture of the product or process. Misuse of this NOA as an endorsement of any product, for sales, advertising or any other purposes shall automatically terminate this NOA. Failure to comply with any section of this NOA shall be cause for termination and removal of NOA.

ADVERTISEMENT: The NOA number preceded by the words Miami-Dade County, Florida, and followed by the expiration date may be displayed in advertising literature. If any portion of the NOA is displayed, then it shall be done in its entirety.

INSPECTION: A copy of this entire NOA shall be provided to the user by the manufacturer or its distributors and shall be available for inspection at the job site at the request of the Building Official.

This NOA revises NOA # 13-1017.03 and consists of this page 1 and evidence page E-1, as well as approval document mentioned above.

The submitted documentation was reviewed by Carlos M. Utrera, P.E.



[Signature]
06/11/2014

NOA No. 14-0423.21
Expiration Date: February 4, 2019
Approval Date: June 19, 2014
Page 1

NOTICE OF ACCEPTANCE: EVIDENCE SUBMITTED

A. DRAWINGS “Submitted under NOA # 11-1117.08”

1. Drawing No. 1624, titled “Model EAV-81 Impact Louver System”, sheets 1 through 3 of 3, dated 11/12/2008, with revision A1, dated 11/08/2011, prepared by W. W. Schaefer Engineering & Consulting, P.A. signed and sealed by Warren W. Schaefer, P.E.

B. TESTS “Submitted under NOA No. 08-1202.08”

1. Test reports on: 1) Uniform Static Air Pressure Test, Loading per FBC TAS 202-94
2) Large Missile Impact Test per FBC, TAS 201-94 and
ASTM E1886/1996 Level E.
3) Cyclic Wind Pressure per FBC, TAS 203-94 and
ASTM E1886/1996.
along with marked-up drawings and installation diagram, of their A-820 Aluminum Louver System", prepared by Hurricane Test Laboratory, Inc., Report No. 0198-0812-08, dated 10/14/2008, signed and sealed by Vinu J. Abraham, P.E.
2. Test report on Wind and Wind-Driven Rain Resistance per TAS 100(A)-95 of their A-820 Louver, prepared by PRI Construction Materials Technologies, LLC, and Report No. 009-02-02, dated 04/28/2008, signed and sealed by Duc T. Nguyen, P.E.

C. CALCULATIONS “Submitted under NOA No. 08-1202.08”

1. Anchoring calculations prepared by W.W. Schaefer Engineering & Consulting, P.A., dated 11/24/2008, signed and sealed by Warren W. Schaefer, P.E.

D. QUALITY ASSURANCE

1. Miami-Dade Department of Regulatory and Economic Resources (RER)

E. MATERIAL CERTIFICATIONS

1. None.

F. STATEMENTS

1. Statement letter of code conformance to 2010 and 5th edition (2014) FBC issued by W. W. Schaefer Engineering & Consulting, P.A., dated 09/03/2013, signed and sealed by Warren W. Schaefer, P.E.

“Submitted under NOA No. 13-1017.03”

2. No financial interest letter issued by W. W. Schaefer Engineering & Consulting, P.A., dated 09/04/2013, signed and sealed by Warren W. Schaefer, P.E.


06/11/2014

Carlos M. Utrera, P.E.

Product Control Examiner

NOA No. 14-0423.21

Expiration Date: February 4, 2019

Approval Date: June 19, 2014

GENERAL NOTES:

1. THESE LOUVER SYSTEMS HAVE BEEN TESTED, ANALYZED & APPROVED FOR DESIGN PRESSURES NOT TO EXCEED THOSE SHOWN IN THE "ALLOWABLE DESIGN PRESSURE TABLE(S)".
2. OPENINGS, BUCKING & BUCKING FASTENERS MUST BE PROPERLY DESIGNED & INSTALLED TO TRANSFER WIND LOADS TO THE STRUCTURE. IT SHALL BE THE RESPONSIBILITY OF THE PERMIT HOLDER TO VERIFY THE STRUCTURAL INTEGRITY OF THE EXISTING STRUCTURE TO SUPPORT THE LOADS SUPERIMPOSED BY THE LOUVERS.
3. ALL HARDWARE & FASTENERS SHALL BE IN ACCORDANCE WITH THESE DRAWINGS & SHALL NOT VARY UNLESS SPECIFICALLY MENTIONED ON THE DRAWINGS. SPECIFIED ANCHOR EMBED TO BASE MATERIAL SHALL BE BEYOND WALL FINISH OR STUCCO.
4. THE DETAILS & SPECIFICATIONS SHOWN HEREIN REPRESENT THE PRODUCTS TESTED & PROPOSED FOR WATER, AIR, IMPACT, CYCLIC & UNIFORM STATIC AIR PRESSURE TESTING IN CONFORMANCE WITH THE FLORIDA BUILDING CODE PROTOCOLS TAS-101, 201, 202 & 203 FOR LARGE MISSILE IMPACT LOUVERS & ASTM E1886 & E1996 FOR ESSENTIAL FACILITIES LEVEL "E" 80 FT/S LARGE MISSILE IMPACT SPEED. THEREFORE, THESE LOUVER SYSTEMS ARE APPROVED FOR USE WITH ESSENTIAL FACILITIES.
5. THESE LOUVER SYSTEMS HAVE BEEN DESIGNED IN ACCORDANCE WITH AND MEET THE REQUIREMENTS OF THE FLORIDA BUILDING CODE (FBC) INCLUDING HIGH VELOCITY HURRICANE ZONES (HVHZ).
6. IMPACT SHUTTERS ARE NOT REQUIRED WITH THESE LOUVERS.
7. ALL ANCHORS SECURING FRAME TO PRESSURE TREATED BUCKS OR WOOD FRAMING SHALL BE CAPABLE OF RESISTING CORROSION CAUSED BY THE PRESSURE TREATING CHEMICALS IN THE WOOD.
8. DETERMINE THE POSITIVE & NEGATIVE DESIGN LOADS TO USE WHEN REFERENCING THESE DOCUMENTS IN ACCORDANCE WITH THE GOVERNING CODE AND GOVERNING WIND VELOCITY. FOR WIND LOAD CALCULATIONS IN ACCORDANCE WITH THE FLORIDA BUILDING CODE, A DIRECTIONALITY FACTOR OF $K_d = 0.85$ MAY BE APPLIED PER THE ASCE 7 STANDARD.
9. NO INCREASE IN ALLOWABLE STRESS HAS BEEN USED IN THE CERTIFICATION OF THIS PRODUCT. WIND LOAD DURATION FACTOR $C_d = 1.6$ WAS USED FOR WOOD SCREW ANALYSIS ONLY.
10. MATERIALS, INCLUDING BUT NOT LIMITED TO STEEL SCREWS, THAT COME INTO CONTACT WITH OTHER DISSIMILAR MATERIALS SHALL MEET THE REQUIREMENTS OF FLORIDA BUILDING CODE CHAPTER 20.
11. EACH LOUVER ASSEMBLY SHALL BE PERMANENTLY LABELED AS FOLLOWS:
ARROW UNITED INDUSTRIES
WYALUSING, PA
MIAMI-DADE COUNTY PRODUCT CONTROL APPROVED
12. THIS SYSTEM HAS BEEN TESTED FOR WATER INFILTRATION RESISTANCE AND IS A WATER RESISTANT SYSTEM.
13. INDIVIDUAL PANEL WIDTHS ARE UNLIMITED IN DIMENSION. PANEL HEIGHTS ARE LIMITED BY THE DIMENSIONS SHOWN IN THE ELEVATIONS.

CORNER & BLADE END CONSTRUCTION:

FRAME: THE HORIZONTAL FRAME MEMBERS RUN THROUGH WHILE THE VERTICAL MEMBERS ARE MITER CUT, BUTTED & SECURED WITH A CONTINUOUS WELD ALONG THE CORNER SEAM.
EXTERIOR BLADE: THE BLADE IS SQUARE CUT & SECURED TO THE SILL VIA A 1/8" X 1 1/4" LONG WELD. FOR LOCATIONS SEE DETAILS B/2 & C/2
INTERIOR BLADE: THE BLADE IS SQUARE CUT & SECURED TO THE FRAME VIA A SLIP FIT PROCESS WHERE THE BLADE IS SANDWICHED BETWEEN THE "Z" & "L" BLADE COMBS.

FRAME ANCHOR REQUIREMENTS TABLE

FRAME/CLIP SCREWS

OPENING TYPE (SUBSTRATE)	FRAME/CLIP TO OPENING FASTENER TYPE	MINIMUM EMBED	MINIMUM EDGE DIST.
MIN. 2X WOOD FRAME OR BUCK (MIN. GR. 3 & G=0.55)	MIN. NO. 10 SMS OR WOOD SCREW	1 1/4"	3/4"
MIN. 16 GA. 33 KSI METAL STUD	MIN. NO. 10 GR. 5 SELF TAP/DRILL SCREW	FULL	1/2"
MIN. 1/8" THK A36 STEEL	MIN. NO. 10 GR. 5 SELF TAP/DRILL SCREW OR 1/4" BOLT (1)	FULL	1/2"
MIN. 1/8" THK 6063-T5 ALUM.	MIN. NO. 10 GR. 5 SELF TAP/DRILL SCREW	FULL	1/2"
3000 PSI CONCRETE	(2) 1/4" CONCRETE SCREW	1 1/2"	2"

- (1) BOLTS SHALL BE MIN. A307 GALVANIZED OR 304 S.S. ($F_v = 10,000$ PSI MIN.)
- (2) CONCRETE SCREWS SHALL BE ELCO ULTRACONS, ITW RAMSET/RED HEAD TAPCONS, HILTI KWIK-CON II OR POWERS RAWL TAPPER (HARDENED STEEL OR S.S.).

PRODUCT REVISED
as complying with the Florida
Building Code
Acceptance No. 14-0423.21
Expiration Date 02/04/2019
By *[Signature]*
Miami Dade Product Control

2" TO 6" MAX. SEE
ALLOWABLE PRESSURE
TABLE ON THIS SHEET

6" MAX.
95 1/2" MAX. FRAME HEIGHT
47 3/4" MAX.
6" MAX.
4" TO 12" MAX. O.C.
SEE ALLOWABLE PRESSURE
TABLE ON THIS SHEET

EXTERIOR ELEVATION: SINGLE LOUVER PANEL

SCALE: 1/2" = 1'-0"

UNLIMITED MAX.
FRAME WIDTH
(SEE GENERAL
NOTE #13)

A1 A2 A3 A4
2 2 2 2

BE ADVISED THAT THE
MANUFACTURER DOES NOT
TYPICALLY SUPPLY INDIVIDUAL
LOUVER PANEL SIZES IN
EXCESS OF 32 SF

2" TO 6" MAX. SEE
ALLOWABLE PRESSURE
TABLE ON THIS SHEET

6"Z" BLADE COMB

6"Z" BLADE COMB
REQUIRED WITH ALL
LOUVER PANELS
HAVING A FRAME
HEIGHT GREATER
THAN 47 3/4"

7"L" BLADE COMB

6"Z" BLADE COMB

FRAME/CLIP SCREWS WHERE
SHOWN. SEE "FRAME ANCHOR
REQUIREMENTS TABLE" ON THIS
SHEET FOR REQUIREMENTS.

ALLOWABLE DESIGN PRESSURE & ANCHOR SPACING REQUIREMENTS (ALL LOUVER CONDITIONS)

MAX. ANCHOR SPACING	MAX. ANCHOR END DISTANCE	ALLOWABLE PRESSURE
4"	2"	+/-150 PSF
8"	4"	+/-75 PSF
12"	6"	+/-50 PSF

PRODUCT RENEWED
as complying with the Florida
Building Code
Acceptance No. 13-1017.03
Expiration Date 02/04/2019
By *[Signature]*
Miami Dade Product Control


EXTERIOR ELEVATION: MULTIPLE LOUVER PANELS

SCALE: 1/2" = 1'-0"

MULTIPLE UNIT NOTES:







1. FOR ALL DETAIL NOT SHOWN, SEE INDIVIDUAL UNIT ELEVATION.
2. THERE IS NO LIMIT ON THE NUMBER OF SINGLE LOUVER PANELS THAT MAY BE COMBINED HORIZONTALLY INTO ONE OPENING PROVIDING THE OPENING IS DESIGNED TO SUPPORT ALL LOADS TRANSFERRED BY THE PANELS.
3. INDIVIDUAL LOUVER PANEL SIZES SHALL BE RESTRICTED AS SPECIFIED IN THE SINGLE LOUVER PANEL ELEVATION.

PRODUCT REVISED
as complying with the Florida
Building Code
Acceptance No. 11-1117.08
Expiration Date 02/04/2014
By *[Signature]*
Miami Dade Product Control


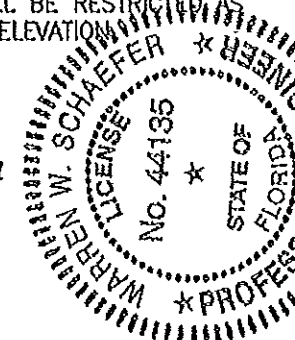


THESE DRAWINGS ARE APPLICABLE ONLY TO THE PRODUCT SPECIFIED. THEY MAY NOT BE USED FOR THE ASSEMBLY AND/OR INSTALLATION OF ANY OTHER PRODUCT NOR MAY THEY BE USED FOR RATIONAL AND/OR LOGAL APPROVAL OF ANY PRODUCT NOT PRODUCED BY THE MANUFACTURER STATED ON THESE DRAWINGS.


DRAWN BY: W.R.U.		CHECKED BY: R.M.S.	
PLOT: 1-24		DATE: 11/12/03	
DATE: 11/06/11	BY: W.R.U.	DATE: 11/06/11	BY: W.R.U.
REVISION DESCRIPTION	MANUFACTURER'S ADDRESS	REVISION DESCRIPTION	MANUFACTURER'S ADDRESS
NO. 1	UPDATE CONSULTANTS & MANUFACTURERS ADDRESS	NO. 1	UPDATE CONSULTANTS & MANUFACTURERS ADDRESS
<p>DRAWING TITLE: EAV-81 IMPACT LOUVER SYSTEM</p> <p>MANUFACTURER: ARROW UNITED INDUSTRIES 450 RIVERSIDE DRIVE WYALUSING, PA 18853 570-746-1888</p> <p>CONSULTANTS: W. W. SCHAEFER ENGINEERING & CONSULTING, P.A. (CA 6809) 7480 150TH COURT NORTH PALM BEACH GARDENS, FL 33418 PHONE 561-744-3424</p> <p>DATE: 08/08/2011</p> <p>WARREN W. SCHAEFER, P.E. LICENSE NO. 44135</p>			
DRAWING NO. 1624		REV. A	
SHEET NO. 1 OF 3			

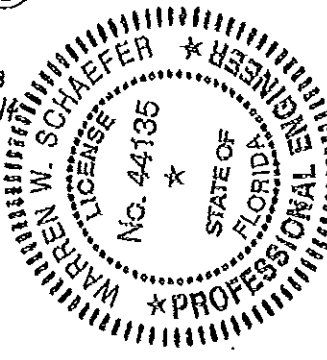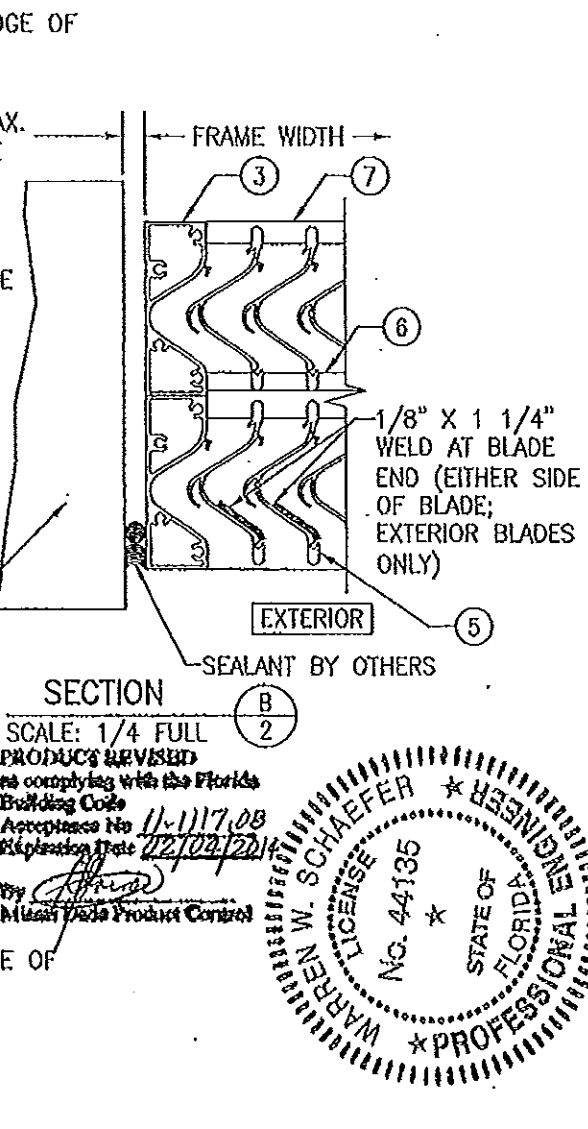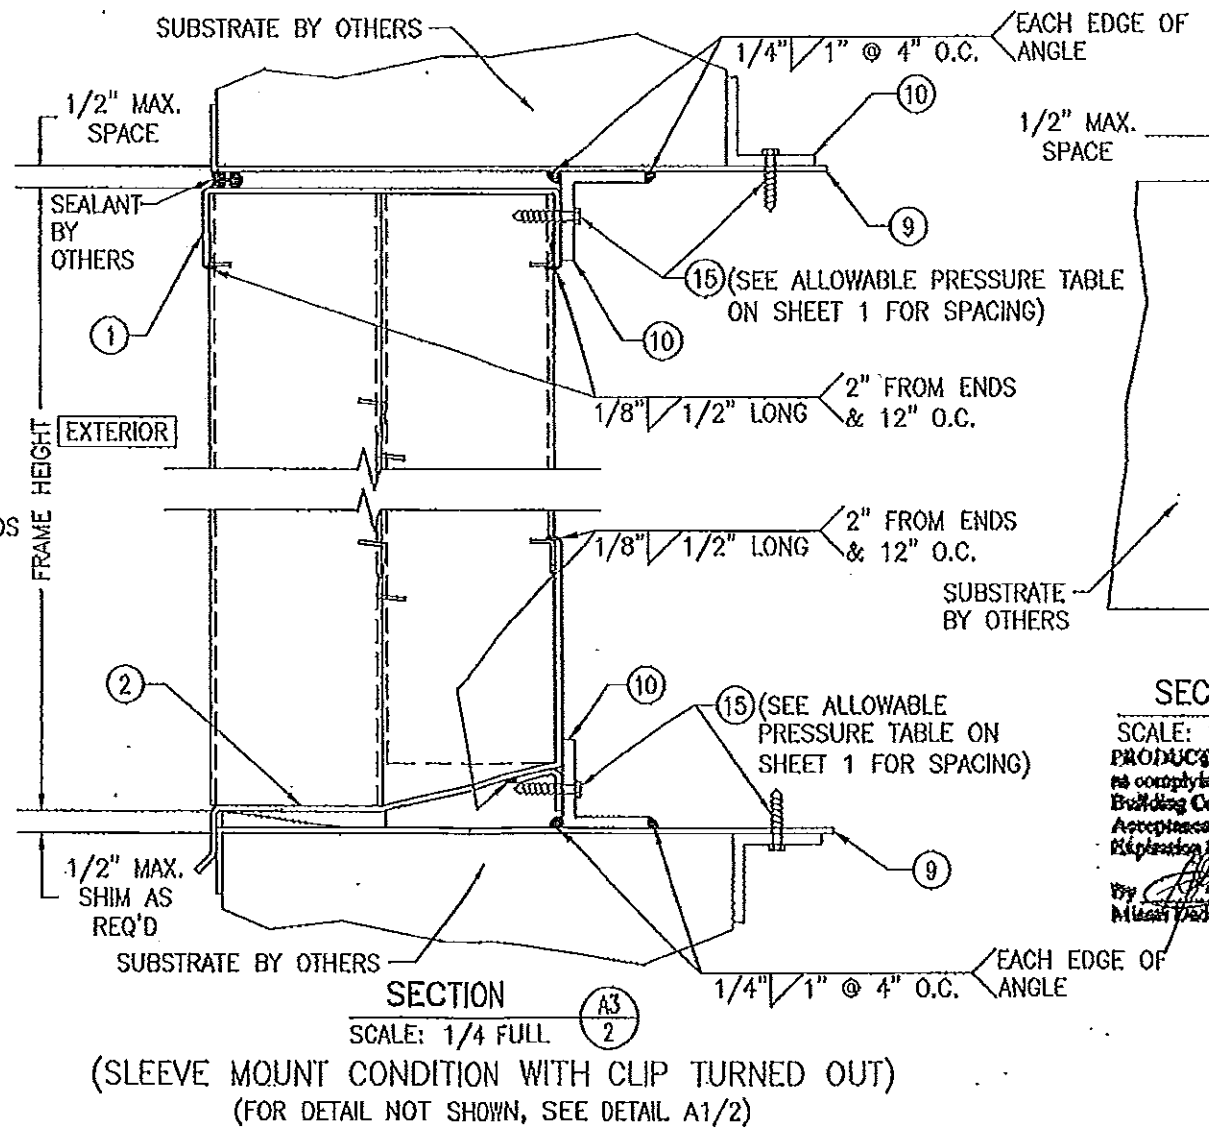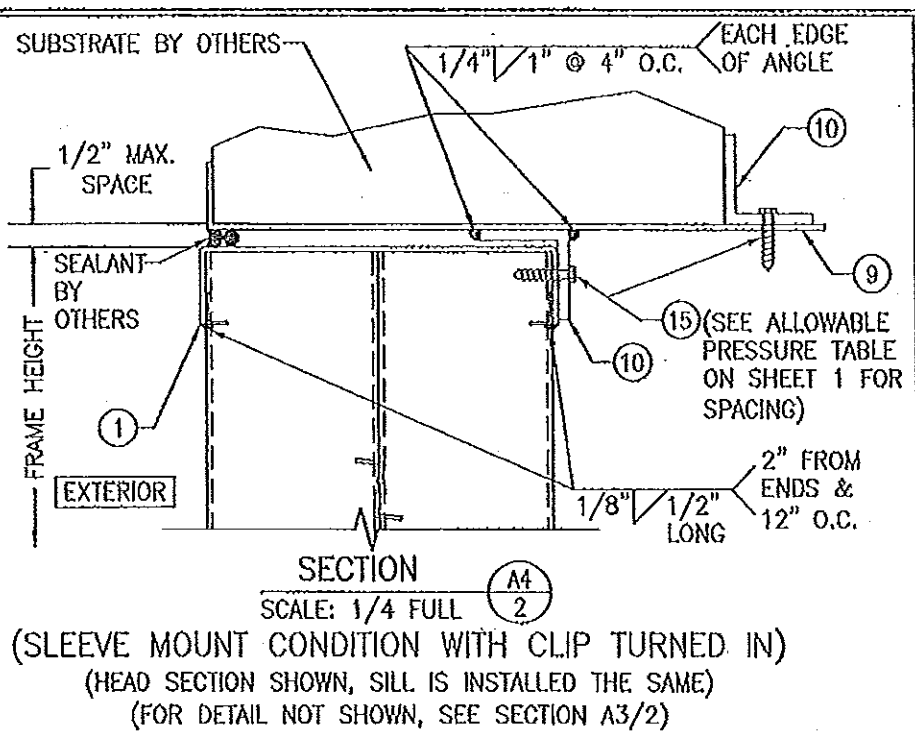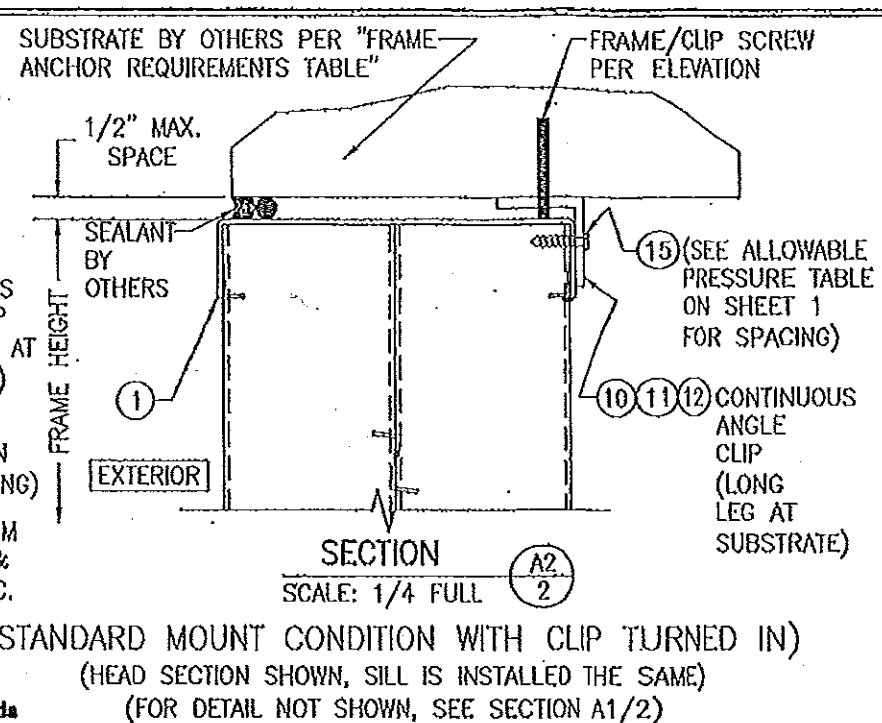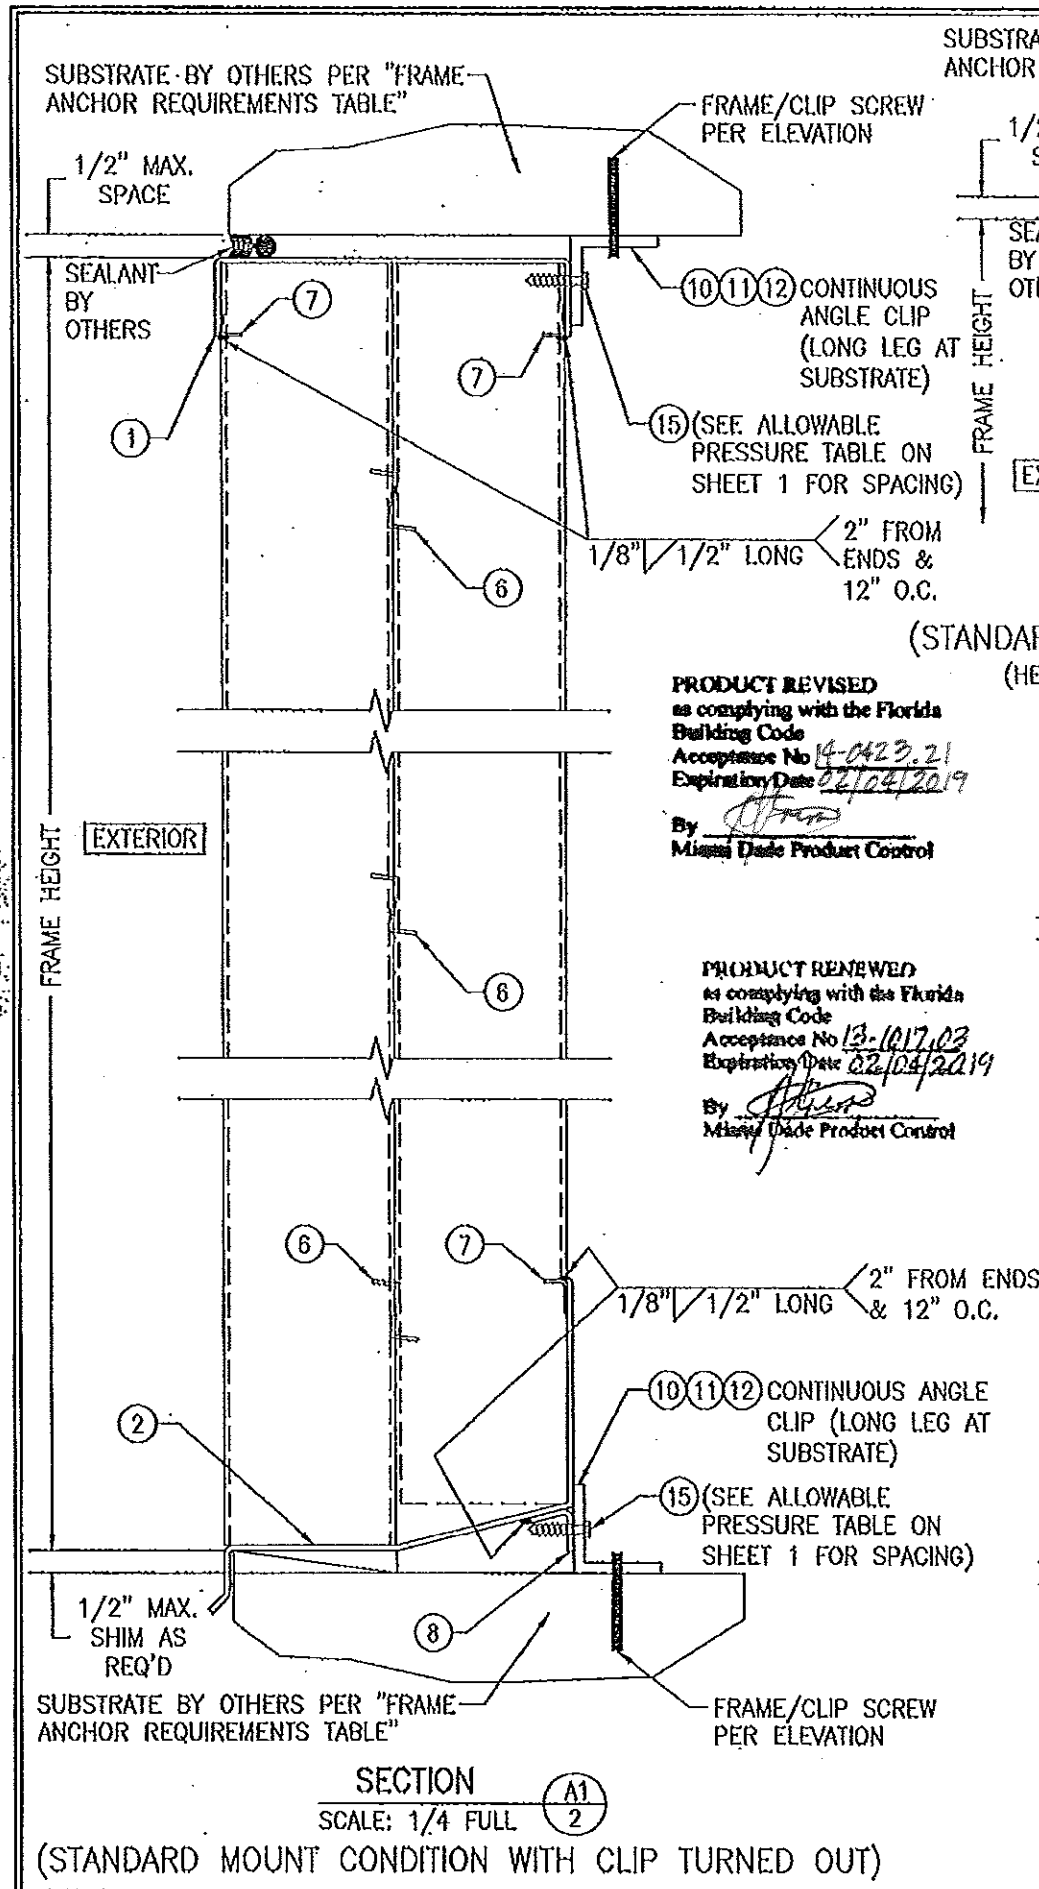


DRAWN BY WRL	CHECKED BY W.M.S.
DATE 11/12/03	DATE 11/12/03
DATE	DATE
BY	BY
REVISION DESCRIPTION	REVISION DESCRIPTION
NO.	NO.
DRAWING TITLE EAV-81 IMPACT LOUVER SYSTEM	
MANUFACTURER ARROW UNITED INDUSTRIES 450 RIVERSIDE DRIVE WYALUSING, PA 18853 570-746-1888	
CONSULTANTS W. W. SCHAEFER ENGINEERING & CONSULTING, P.A. (CA 6809) 7480 150TH COURT NORTH PALM BEACH GARDENS, FL 33418 PHONE 561-744-5424	
CERTIFICATION NOV 08 2011 WARREN W. SCHAEFER P.E. P.E. NO. 44135	
DRAWING NO. 1624	REV. A
SHEET NO. 2	OF 3

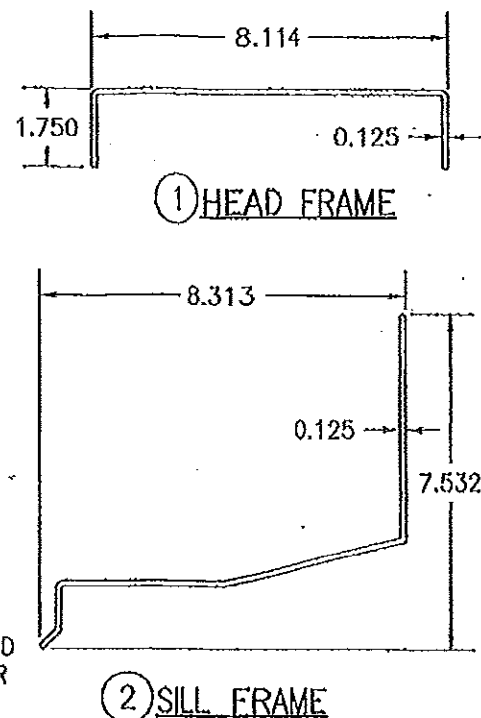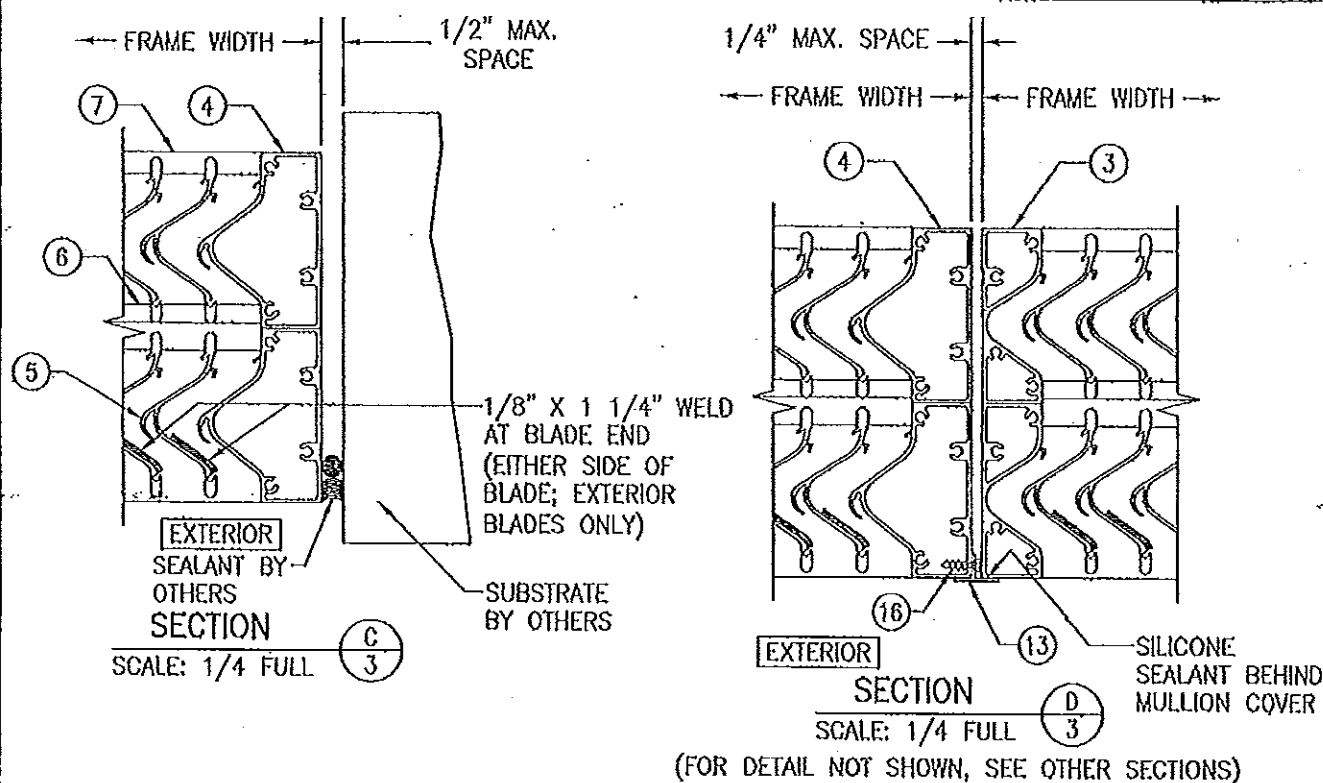


ITEM #	ITEM DESCRIPTION	MANUFACTURER/NOTES
PARTS		
1	HEAD FRAME	5052-H32 ALUMINUM
2	SILL FRAME	5052-H32 ALUMINUM
3	JAMB (FEMALE)	6063-T5 ALUMINUM
4	JAMB (MALE)	6063-T5 ALUMINUM
5	BLADE	6063-T5 ALUMINUM
6	"Z" BLADE COMB	5052-H32 ALUMINUM
7	"L" BLADE COMB	5052-H32 ALUMINUM
8	SILL MOUNTING ANGLE	5052-H32 ALUMINUM
9	MOUNTING SLEEVE	5052-H32 ALUMINUM
10	CONTINUOUS MOUNTING CLIP	6063-T5 ALUMINUM
11	CONTINUOUS MOUNTING CLIP	6063-T5 ALUMINUM
12	CONTINUOUS MOUNTING CLIP	6063-T5 ALUMINUM
13	MULLION COVER	6063-T5/T6 ALUMINUM
MISC. FASTENERS		
15	NO. 14 X 1 1/4" 410 SS TEK SCREW	FOR SPACING REQUIREMENTS SEE ALLOWABLE PRESSURE TABLE ON SHEET 1
16	NO. 8 X 3/4" 18-8 SS SMS SCREW	WITHIN 2" FROM ENDS & MAX. 15" O.C.

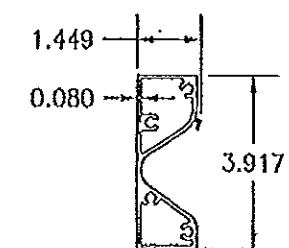


3 JAMB (FEMALE)

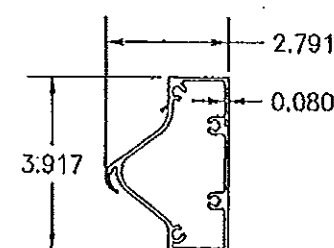


4 JAMB (MALE)

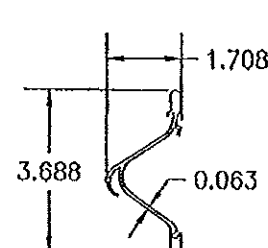

5 BLADE

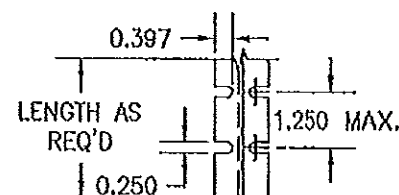


6 "Z" BLADE COMB

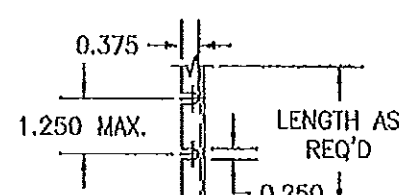


7 "L" BLADE COMB

PRODUCT REVISED
as complying with the Florida
Building Code
Acceptance No. 14-0423-21
Expiration Date 02/04/2019
By: [Signature]
Miami Made Product Control


PRODUCT RENEWED
as complying with the Florida
Building Code
Acceptance No. 13-1017-03
Expiration Date 02/04/2019
By: [Signature]
Miami Made Product Control

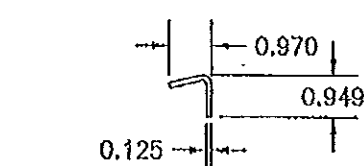


8 SILL MOUNTING ANGLE

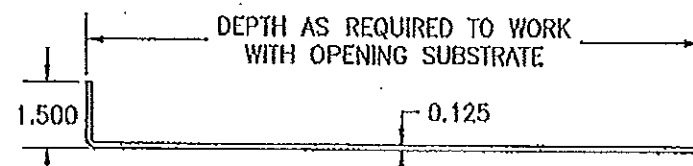


9 MOUNTING SLEEVE

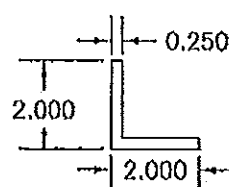


10 CONTINUOUS MOUNTING CLIP

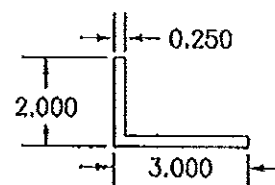

11 CONTINUOUS MOUNTING CLIP

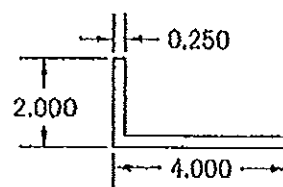


12 CONTINUOUS MOUNTING CLIP

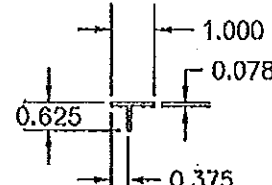

13 MULLION COVER

PRODUCT REVISED
as complying with the Florida
Building Code
Acceptance No. 11-1117-08
Expiration Date 02/04/2019
By: [Signature]
Miami Made Product Control

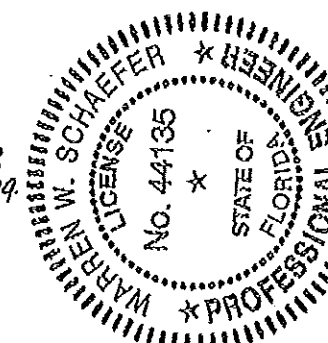

DRAWING TITLE EAV-81 IMPACT LOUVER SYSTEM		DRAWN BY W.M.		CHECKED BY W.M.S.	
DATE 11/12/03		DATE 11/12/03		DATE 11/12/03	
BY [Signature]		BY [Signature]		BY [Signature]	
REVISION DESCRIPTION		REVISION DESCRIPTION		REVISION DESCRIPTION	
NO.	REVISION DESCRIPTION	NO.	REVISION DESCRIPTION	NO.	REVISION DESCRIPTION
<p>MANUFACTURER ARROW UNITED INDUSTRIES 450 RIVERSIDE DRIVE WYLLISSING, PA 18853 570-746-1888</p> <p>CONSULTANTS W. W. SCHAEFER ENGINEERING & CONSULTING, P.A. (CA 6809) 7480 150TH COURT NORTH PALM BEACH GARDENS, FL 33418 PHONE 561-744-3424</p> <p>CERTIFICATION NOV 08 2011 WARREN W. SCHAEFER, P.E. P.E. NO. 44135</p>					
DRAWING NO. 1624		REV. A		SHEET NO. 3 OF 3	